

Draw. C-2 of  
 DCS No.  
 BA-000-787-001  
 Date: 15 APRIL 1983  
 Scale: 1" = 50'



NO.	TOP	INVERTS	NOTES
1	2792.85	2792.85	13.35
2	2792.85	2792.85	13.35
3	2792.85	2792.85	13.35
4	2792.85	2792.85	13.35
5	2792.85	2792.85	13.35

PROPERTY CURVE DATA			
NO.	RAD.	DELTA	CHORD
1	2792.85	2792.85	2792.85
2	2792.85	2792.85	2792.85
3	2792.85	2792.85	2792.85
4	2792.85	2792.85	2792.85
5	2792.85	2792.85	2792.85

EASEMENT CURVE DATA			
NO.	RAD.	DELTA	CHORD
1	2792.85	2792.85	2792.85
2	2792.85	2792.85	2792.85
3	2792.85	2792.85	2792.85
4	2792.85	2792.85	2792.85
5	2792.85	2792.85	2792.85

PROPERTY DATA			
STATION	ELEV.	BEARING	DEPARTURE
1	2792.85	2792.85	2792.85
2	2792.85	2792.85	2792.85
3	2792.85	2792.85	2792.85
4	2792.85	2792.85	2792.85
5	2792.85	2792.85	2792.85

EASEMENT DATA			
STATION	ELEV.	BEARING	DEPARTURE
1	2792.85	2792.85	2792.85
2	2792.85	2792.85	2792.85
3	2792.85	2792.85	2792.85
4	2792.85	2792.85	2792.85
5	2792.85	2792.85	2792.85

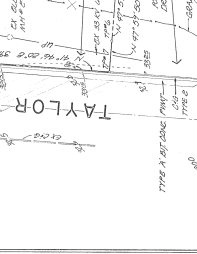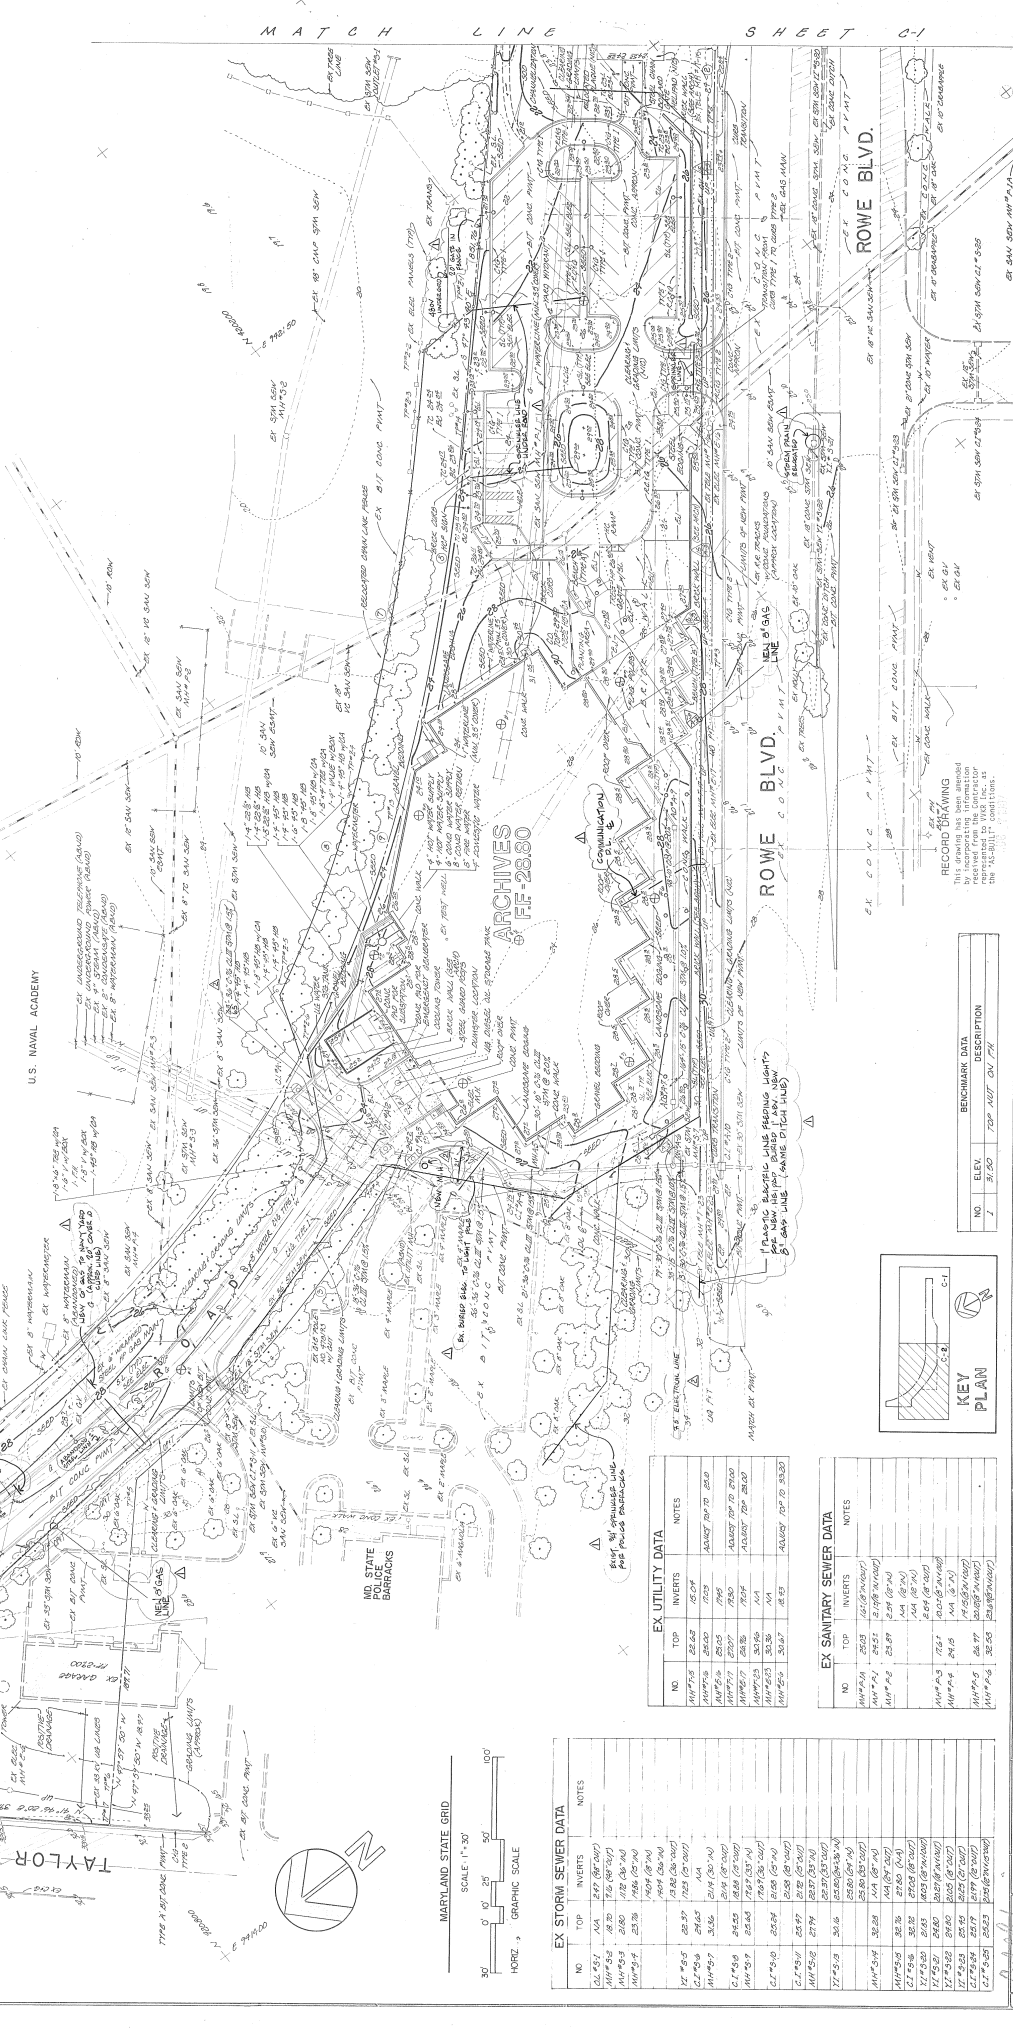

EX UTILITY DATA			
NO.	TOP	INVERTS	NOTES
1	2792.85	2792.85	13.35
2	2792.85	2792.85	13.35
3	2792.85	2792.85	13.35
4	2792.85	2792.85	13.35
5	2792.85	2792.85	13.35

EX SANITARY SEWER DATA			
NO.	TOP	INVERTS	NOTES
1	2792.85	2792.85	13.35
2	2792.85	2792.85	13.35
3	2792.85	2792.85	13.35
4	2792.85	2792.85	13.35
5	2792.85	2792.85	13.35

EX STORM SEWER DATA			
NO.	TOP	INVERTS	NOTES
1	2792.85	2792.85	13.35
2	2792.85	2792.85	13.35
3	2792.85	2792.85	13.35
4	2792.85	2792.85	13.35
5	2792.85	2792.85	13.35

**SITE PLAN**  
 Maryland State Archives Building  
 Annapolis, Maryland

Date	Revisions
9/1/81	1. AS-BUILT RECORD DOCUMENTS
11/5/82	2. REVISED FOR RECORD DOCUMENTS

DEPARTMENT OF GENERAL SERVICES  
 PROJECT ADMINISTRATOR: [Signature]  
 DATE: [Blank]  
 DIRECTOR, ENR & CONST. [Signature]

USING AGENCY APPROVAL: [Signature]

**WVCR Incorporated**  
 Architecture, Engineering, Planning